THIS DRAWING IS UNPUBLISHED. RELEASED FOR PUBLICATION -,- .
© COPYRIGHT - BY TYCO ELECTRONICS CORPORATION. ALL RIGHTS RESERVED.

LOC	DIST
DW	—

REVISIONS

P	LTR	DESCRIPTION	DATE	DWN	APVD
	D	REVISED (ECR-11-020274)	04OCT11	JC	WK

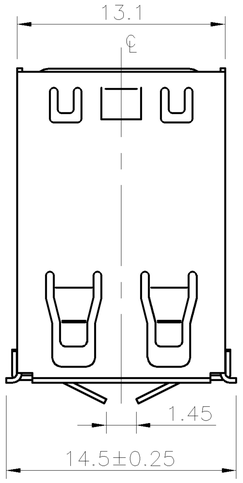

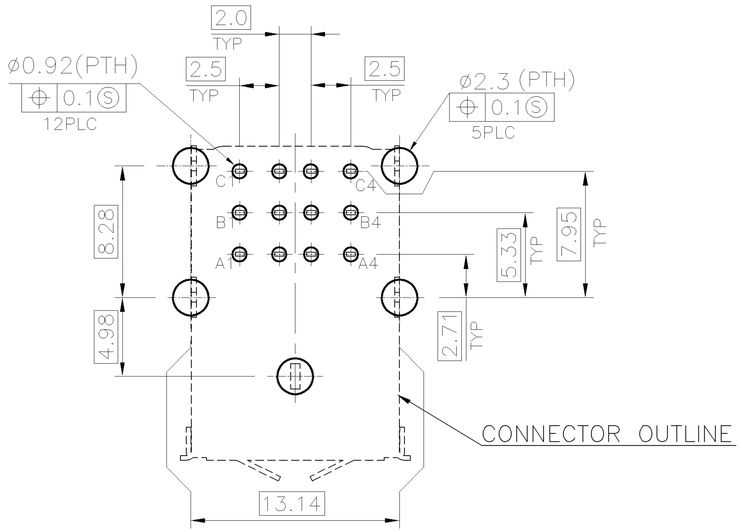

RECOMMENDED PCB LAYOUT
TOLERANCE: ±0.05mm

NOTES:

1. MATERIAL:
   HOUSING: A. PA6T WITH 30% GF, UL 94V-0, COLOR: SEE TABLE.
   ⬟ B. PA9T WITH 33% GF, UL 94V-0, COLOR: BLACK.
   CONTACTS: PHOSPHOR BRONZE.
   SHELL: PHOSPHOR BRONZE.
   SPRING: STAINLESS.
   REAR SHELL: PHOSPHOR BRONZE.

2. FINISH:
   CONTACTS: GOLD PLATING (SEE TABLE) IN CONTACT AREA,
   2.54µm[100µ"] MIN. MATTE TIN PLATING ON SOLDERTAILS,
   1.27µm[50µ"] MIN. NICKEL UNDERPLATED OVER ALL.
   SHELL: A. 2.54µm[100µ"] MIN. BRIGHT TIN PLATING OVER
   1.27µm[50µ"] MIN. NICKEL UNDERPLATED. OR
   ⬟ B. 2.54µm[100µ"] MIN. NICKEL PLATING OVER ALL.
   SPRING: 1.27µm[50µ"] MIN. NICKEL PLATING.
   REAR SHELL: 1.27µm[50µ"] MIN. NICKEL PLATING.

3. RECOMMENDED PCB THICKNESS: 1.6mm.

4. WAVE SOLDER CAPABLE TO 265° PER TE CONNECTIVITY SPEC. 109-202, CONDITION B.
⬟ 5. RELOW SOLDER CAPABLE TO 260° PER TE CONNECTIVITY SPEC. 109-201, CONDITION B.

6. "⬟" APPLIED FOR 1-1734309-5 ONLY

△7 OBSOLETE PARTS: OBSOLETE CIS STREAMLINING PER D.RENAUD/D.SINISI

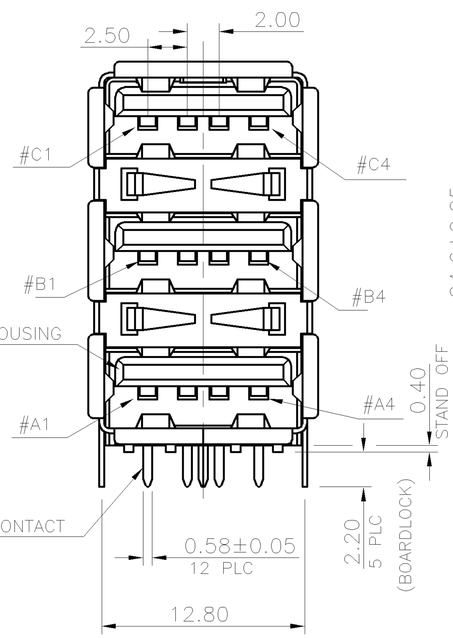

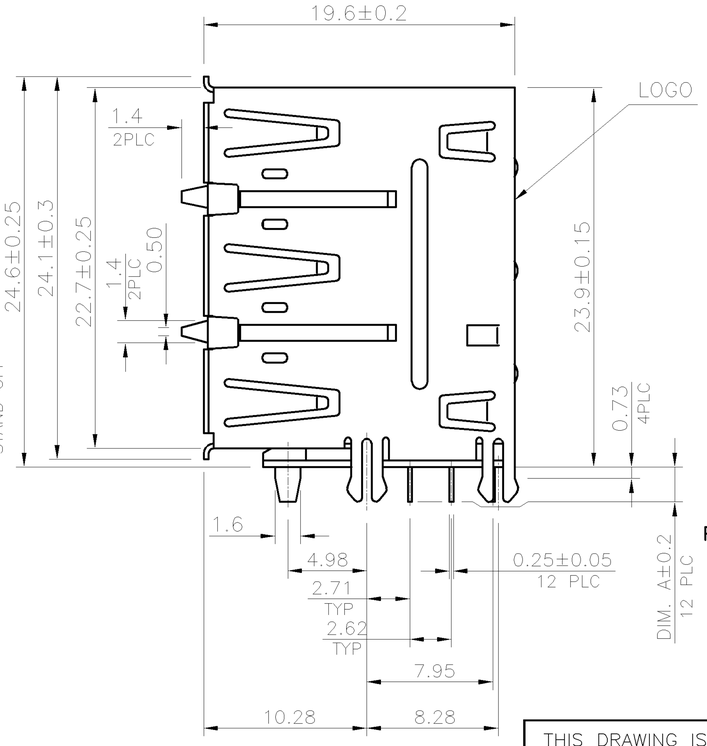

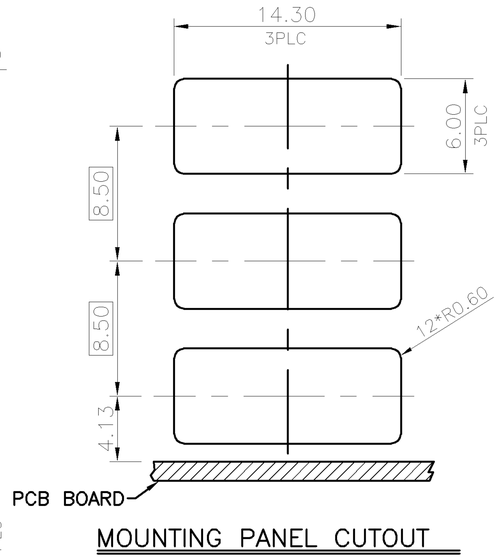

MOUNTING PANEL CUTOUT

DIM A	HOUSING COLOR	MIN. GOLD THICKNESS	PART NUMBER
2.84	BEIGE (726C)	15µ"	2-1734309-8
	BLACK (426C)	15µ"	2-1734309-7
	BEIGE (726C)	30µ"	2-1734309-6
	BLACK (426C)	30µ"	2-1734309-5
	BEIGE (726C)	5µ"	2-1734309-4
	BLACK (426C)	5µ"	2-1734309-3
	BEIGE (726C)	G/F	2-1734309-2
	BLACK (426C)	G/F	2-1734309-1
2.2	~~BEIGE (726C)~~	~~15µ"~~	~~1734309-8~~
	BLACK (426C)	15µ"	1734309-7
	~~BEIGE (726C)~~	~~30µ"~~	~~1734309-6~~
	BLACK (426C)	30µ"	1734309-5
	~~BEIGE (726C)~~	~~5µ"~~	~~1734309-4~~
	~~BLACK (426C)~~	~~5µ"~~	~~1734309-3~~
	~~BEIGE (726C)~~	~~G/F~~	~~1734309-2~~
	BLACK (426C)	G/F	1734309-1

△7 OBSOLETE
△7 OBSOLETE
△7 OBSOLETE

WITH SPRING

THIS DRAWING IS A CONTROLLED DOCUMENT.

DIMENSIONS: MM

TOLERANCES UNLESS OTHERWISE SPECIFIED:
0 PLC ± -
1 PLC ± 0.30
2 PLC ± 0.25
3 PLC ± 0.20
4 PLC ± -
ANGLES ± 3°

MATERIAL: SEE NOTE
FINISH: SEE NOTE

DWN B. HSING 06FEB2009
CHK S. CHIEN 06FEB2009
APVD W. KODAMA 06FEB2009
PRODUCT SPEC 108-57519
APPLICATION SPEC —
WEIGHT 9.2 GRAMS
CUSTOMER DRAWING

TE Connectivity

NAME
TRIPLE STACKED USB, A TYPE, RECEPTACLE, R/A, DIP CONN.

SIZE	CAGE CODE	DRAWING NO	RESTRICTED TO
A3	00779	C-1734309	—

SCALE	SHEET	REV
—	1 OF 3	D

THIS DRAWING IS UNPUBLISHED. RELEASED FOR PUBLICATION -,- .
© COPYRIGHT - BY TYCO ELECTRONICS CORPORATION. ALL RIGHTS RESERVED.

LOC	DIST
DW	—

REVISIONS

P	LTR	DESCRIPTION	DATE	DWN	APVD
		SEE SHEET 1.			

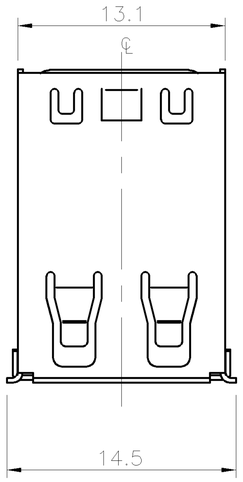

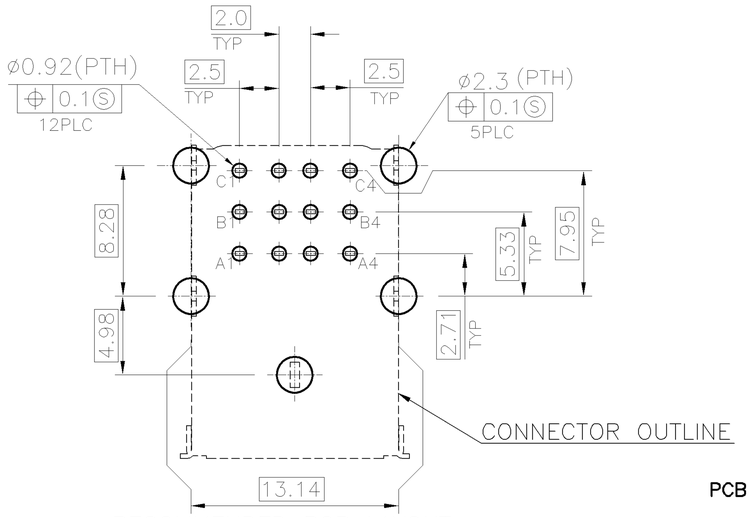

RECOMMENDED PCB LAYOUT
TOLERANCE: ±0.05mm

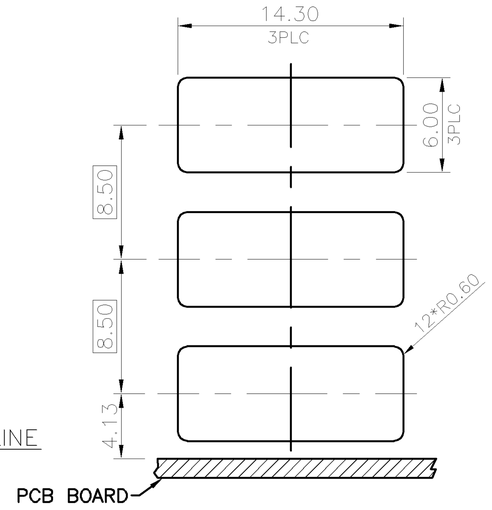

MOUNTING PANEL CUTOUT

WITHOUT SPRING

DIM B	DIM A	HOUSHING COLOR	MIN. GOLD THICKNESS	PART NUMBER
2.84	2.84	BLACK (426C)	15µ"	5-1734309-7
		~~BEIGE (726C)~~	~~15µ"~~	~~3-1734309-8~~
		~~BLACK (426C)~~	~~15µ"~~	~~3-1734309-7~~
		~~BEIGE (726C)~~	~~30µ"~~	~~3-1734309-6~~
		BLACK (426C)	30µ"	3-1734309-5
		~~BEIGE (726C)~~	~~5µ"~~	~~3-1734309-4~~
		~~BLACK (426C)~~	~~5µ"~~	~~3-1734309-3~~
		~~BEIGE (726C)~~	~~C/F~~	~~3-1734309-2~~
		~~BLACK (426C)~~	~~C/F~~	~~3-1734309-1~~
2.2	2.2	~~BEIGE (726C)~~	~~15µ"~~	~~1-1734309-8~~
		BLACK (426C)	15µ"	1-1734309-7
		~~BEIGE (726C)~~	~~30µ"~~	~~1-1734309-6~~
		BLACK (426C)	30µ"	⬟1-1734309-5
		~~BEIGE (726C)~~	~~5µ"~~	~~1-1734309-4~~
		~~BLACK (426C)~~	~~5µ"~~	~~1-1734309-3~~
		~~BEIGE (726C)~~	~~C/F~~	~~1-1734309-2~~
		~~BLACK (426C)~~	~~C/F~~	~~1-1734309-1~~

△7 OBSOLETE

THIS DRAWING IS A CONTROLLED DOCUMENT.

DIMENSIONS: MM

TOLERANCES UNLESS OTHERWISE SPECIFIED:

0 PLC	± –
1 PLC	± 0.30
2 PLC	± 0.25
3 PLC	± 0.20
4 PLC	± –
ANGLES	± 3°

MATERIAL –
FINISH –

DWN
CHK
APVD
PRODUCT SPEC —
APPLICATION SPEC —
WEIGHT 9.0 GRAMS
CUSTOMER DRAWING

TE Connectivity

NAME
TRIPLE STACKED USB, A TYPE, RECEPTACLE, R/A, DIP CONN.

SIZE	CAGE CODE	DRAWING NO	RESTRICTED TO
A3	00779	C-1734309	—

SCALE —
SHEET 2 OF 3
REV D

THIS DRAWING IS UNPUBLISHED. RELEASED FOR PUBLICATION –,– .
© COPYRIGHT – BY TYCO ELECTRONICS CORPORATION. ALL RIGHTS RESERVED.

LOC	DIST
DW	—

REVISIONS

P	LTR	DESCRIPTION	DATE	DWN	APVD
		SEE SHEET 1.			

100PCS/TRAY

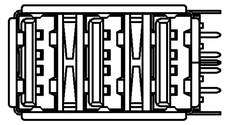

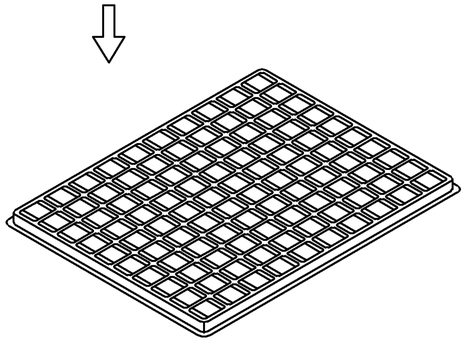

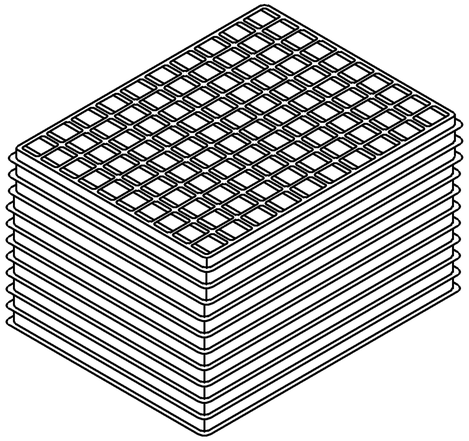

10 LAYERS

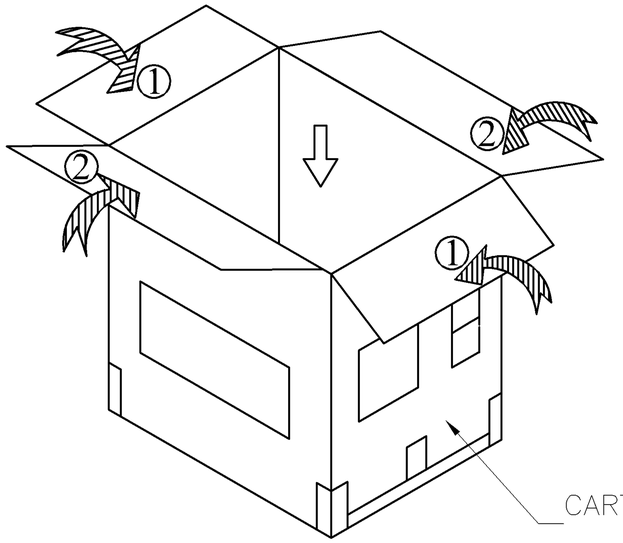

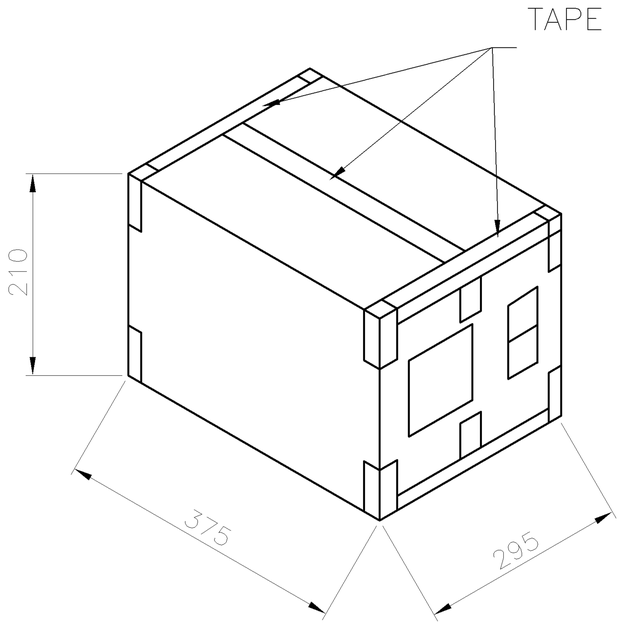

13.0	12.0	100	10	1000
G/W (KG)	N/W (KG)	PCS/ TRAY	TRAY/ CARTON	PCS/ CARTON

THIS DRAWING IS A CONTROLLED DOCUMENT.

DIMENSIONS: MM

TOLERANCES UNLESS OTHERWISE SPECIFIED:
0 PLC ± –
1 PLC ± –
2 PLC ± –
3 PLC ± –
4 PLC ± –
ANGLES ± –

MATERIAL –

FINISH –

DWN
CHK
APVD
PRODUCT SPEC —
APPLICATION SPEC —
WEIGHT —

CUSTOMER DRAWING

TE Connectivity

NAME
TRIPLE STACKED USB, A TYPE, RECEPTACLE, R/A, DIP CONN.

SIZE	CAGE CODE	DRAWING NO	RESTRICTED TO
A3	00779	C-1734309	—

SCALE	SHEET	REV
—	3 OF 3	D

Стандарт Электрон Связь

Мы молодая и активно развивающаяся компания в области поставок электронных компонентов. Мы поставляем электронные компоненты отечественного и импортного производства напрямую от производителей и с крупнейших складов мира.

Благодаря сотрудничеству с мировыми поставщиками мы осуществляем комплексные и плановые поставки широчайшего спектра электронных компонентов.

Собственная эффективная логистика и склад в обеспечивает надежную поставку продукции в точно указанные сроки по всей России.

Мы осуществляем техническую поддержку нашим клиентам и предпродажную проверку качества продукции. На все поставляемые продукты мы предоставляем гарантию .

Осуществляем поставки продукции под контролем ВП МО РФ на предприятия военно-промышленного комплекса России , а также работаем в рамках 275 ФЗ с открытием отдельных счетов в уполномоченном банке. Система менеджмента качества компании соответствует требованиям ГОСТ ISO 9001.

Минимальные сроки поставки, гибкие цены, неограниченный ассортимент и индивидуальный подход к клиентам являются основой для выстраивания долгосрочного и эффективного сотрудничества с предприятиями радиоэлектронной промышленности, предприятиями ВПК и научно-исследовательскими институтами России.

С нами вы становитесь еще успешнее!

Наши контакты:

Телефон: +7 812 627 14 35

Электронная почта: sales@st-electron.ru

Адрес: 198099, Санкт-Петербург,
Промышленная ул, дом № 19, литера Н,
помещение 100-Н Офис 331